




SPACE DIVERSITY MW LINK FACING BOUTA

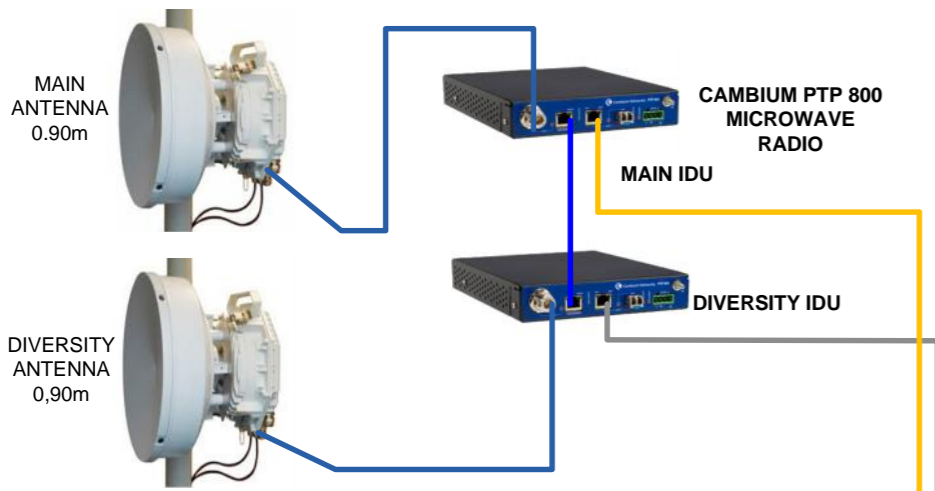





MW BACK BONE NETWORK

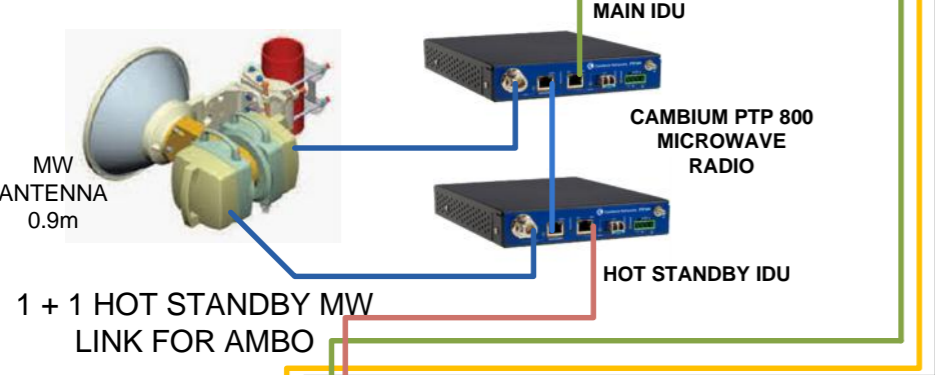

1 + 1 HOT STANDBY MW LINK FOR AMBO

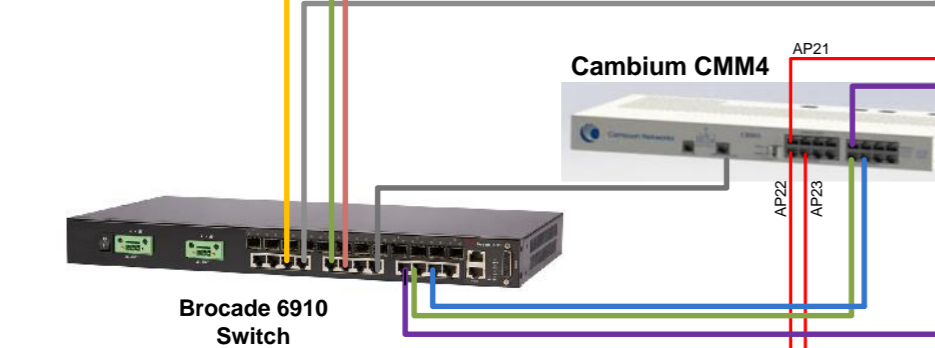

DEKA Uniqy I Deep Cycle Batteries

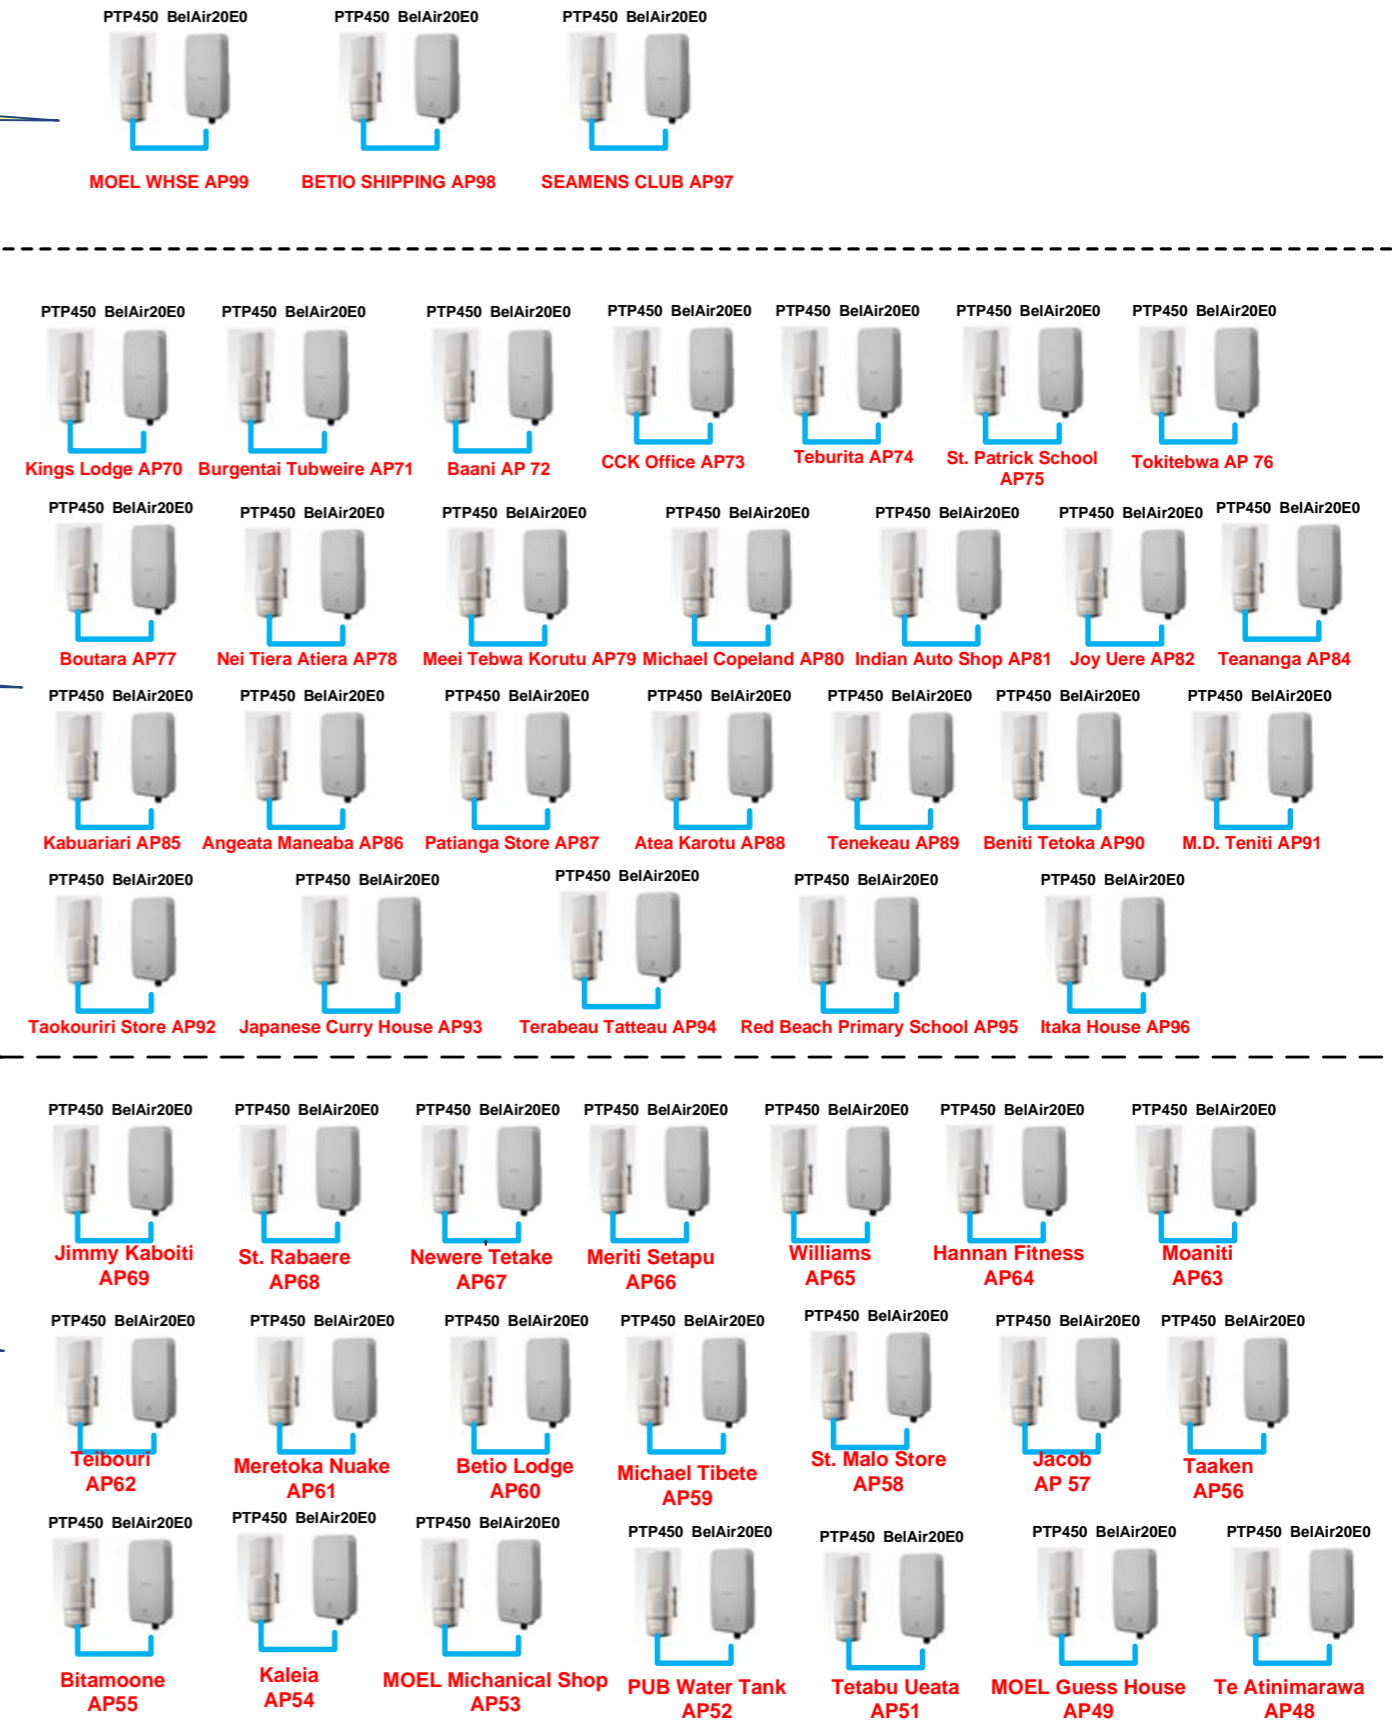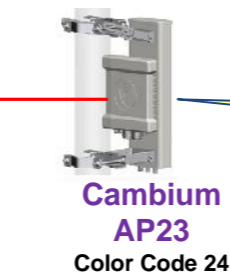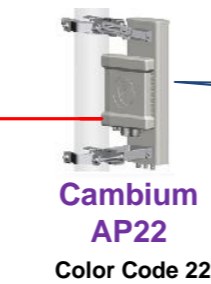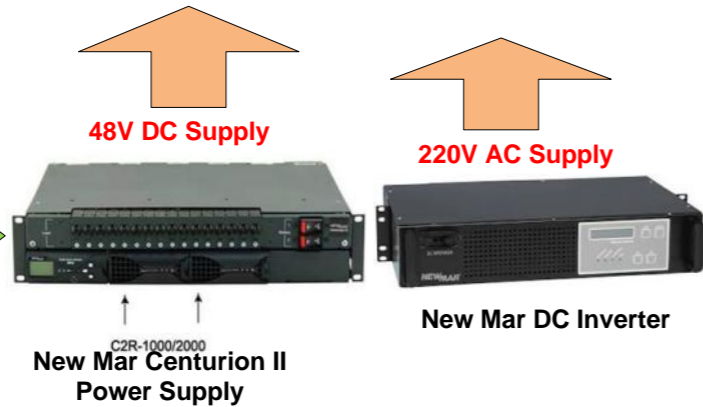

ABS Satellite 3.7m Antenna Disc



SPACE DIVERSITY MW LINK FACING BETIO
 MAIN ANTENNA 0.90m
 DIVERSITY ANTENNA 0.90m

MICROWAVE RADIO BACK BONE NETWORK

CAMBIUM PTP 800 MICROWAVE RADIO
 MAIN IDU
 DIVERSITY IDU
 1 + 1 HOT STANDBY MW LINK FOR AMBO
 MAIN IDU
 Hot Standby

NEWTEC SATELLITE MODEM

CISCO 1900 SERIES ROUTER

Wi-Client

Wi Direct

Brocade 6910 Switch

ERICSSON WIC 8052

CISCO CATALYST 2950 ROUTER

**Cambium AP21
Color Code 21**

**Cambium AP22
Color Code 22**

**DEKA Uniqy I
Deep Cycle Batteries**
 48V DC Back up Power

48V DC Supply
 New Mar Centurion II
 Power Supply

220V AC Supply
 New Mar DC Inverter

MSI LINUX SERVER
 (Ericsson Wireless Manager)
 (Cambium Wireless Manager)


- | | | | | | |
|--|---|---|--|--|---|
| PTP450 BelAir20E0
TINITI GUEST HOUSE AP51 | PTP450 BelAir20E0
MOEL Warehouse AP52 | PTP450 BelAir20E0
INDIAN MECHANIC SHOP AP56 | PTP450 BelAir20E0
WAKAEIA AP 59 | PTP450 BelAir20E0
TEMANGO AP67 | PTP450 BelAir20E0
ROMY Mech Shop AP68 |
| PTP450 BelAir20E0
RURUTEANG UBAUBIA AP72 | PTP450 BelAir20E0
Butirooti AP66 | PTP450 BelAir20E0
Emi Teraaka AP75 | PTP450 BelAir20E0
ARIETA COLD SOLBREW AP74 | PTP450 BelAir20E0
RED CROSS/ MELAD AP78 | PTP450 BelAir20E0
M.EDUCATION EXAM UNIT AP80 |
| PTP450 BelAir20E0
Teebantaake AP83 | PTP450 BelAir20E0
KGV EBS AP85 | PTP450 BelAir20E0
STA MARIA COLLEGE AP87 | PTP450 BelAir20E0
TEACHER AP88 | PTP450 BelAir20E0
KIRIBATI TEACHERS COLLEGE AP89 | PTP450 BelAir20E0
N. War Memorial AP62 |
| PTP450 BelAir20E0
NAKIBAE AP71 | PTP450 BelAir20E0
Andrew Kometa AP81 | PTP450 BelAir20E0
WILLY MEAN AP50 | PTP450 BelAir20E0
Akau Toom AP | PTP450 BelAir20E0
Nutrition Office AP | PTP450 BelAir20E0
Rabangaki AP57 |
| PTP450 BelAir20E0
Tekaawa N Iraorao AP58 | PTP450 BelAir20E0
Manu Cake House AP55 | PTP450 BelAir20E0
Euketa AP54 | PTP450 BelAir20E0
Teritia AP51 | PTP450 BelAir20E0
Airport Runway Tebaunie Bauteriki AP61 | PTP450 BelAir20E0
Airport Runway 2 Tenoa AP60 |
| PTP450 BelAir20E0
Junction Road AP63 | PTP450 BelAir20E0
Korotita AP69 | PTP450 BelAir20E0
Nauan AP64 | PTP450 BelAir20E0
Barai Residence AP70 | PTP450 BelAir20E0
Terimoa AP77 | PTP450 BelAir20E0
James Tokataake AP73 |
| PTP450 BelAir20E0
Terry Tetsuko Store AP82 | PTP450 BelAir20E0
Agriculture Office AP76 | PTP450 BelAir20E0
Newerewere Hospital AP79 | PTP450 BelAir20E0
Thads Guest House AP65 | PTP450 BelAir20E0
Kautu Tekanene AP90 | PTP450 BelAir20E0
Lily AP 84 |
| PTP450 BelAir20E0
Kaitibo AP86 | | | | | |

Wireless Innovation Solution Inc.
 Design | Supply | Integration | Installation | ITS | Consultation

BOUTA WIFI NETWORK AS BUILT PLAN

MOEL TRADING COMPANY
 Moel Trading House
 Betio, Tarawa, REPUBLIC OF KIRIBATI
 Ph: +686 26050, 25000, 26654 Fax: +686 26074,
 E-mail: moeltrading@hotmail.com

SHEET NO.	2
DATE:	
Ref.no.	

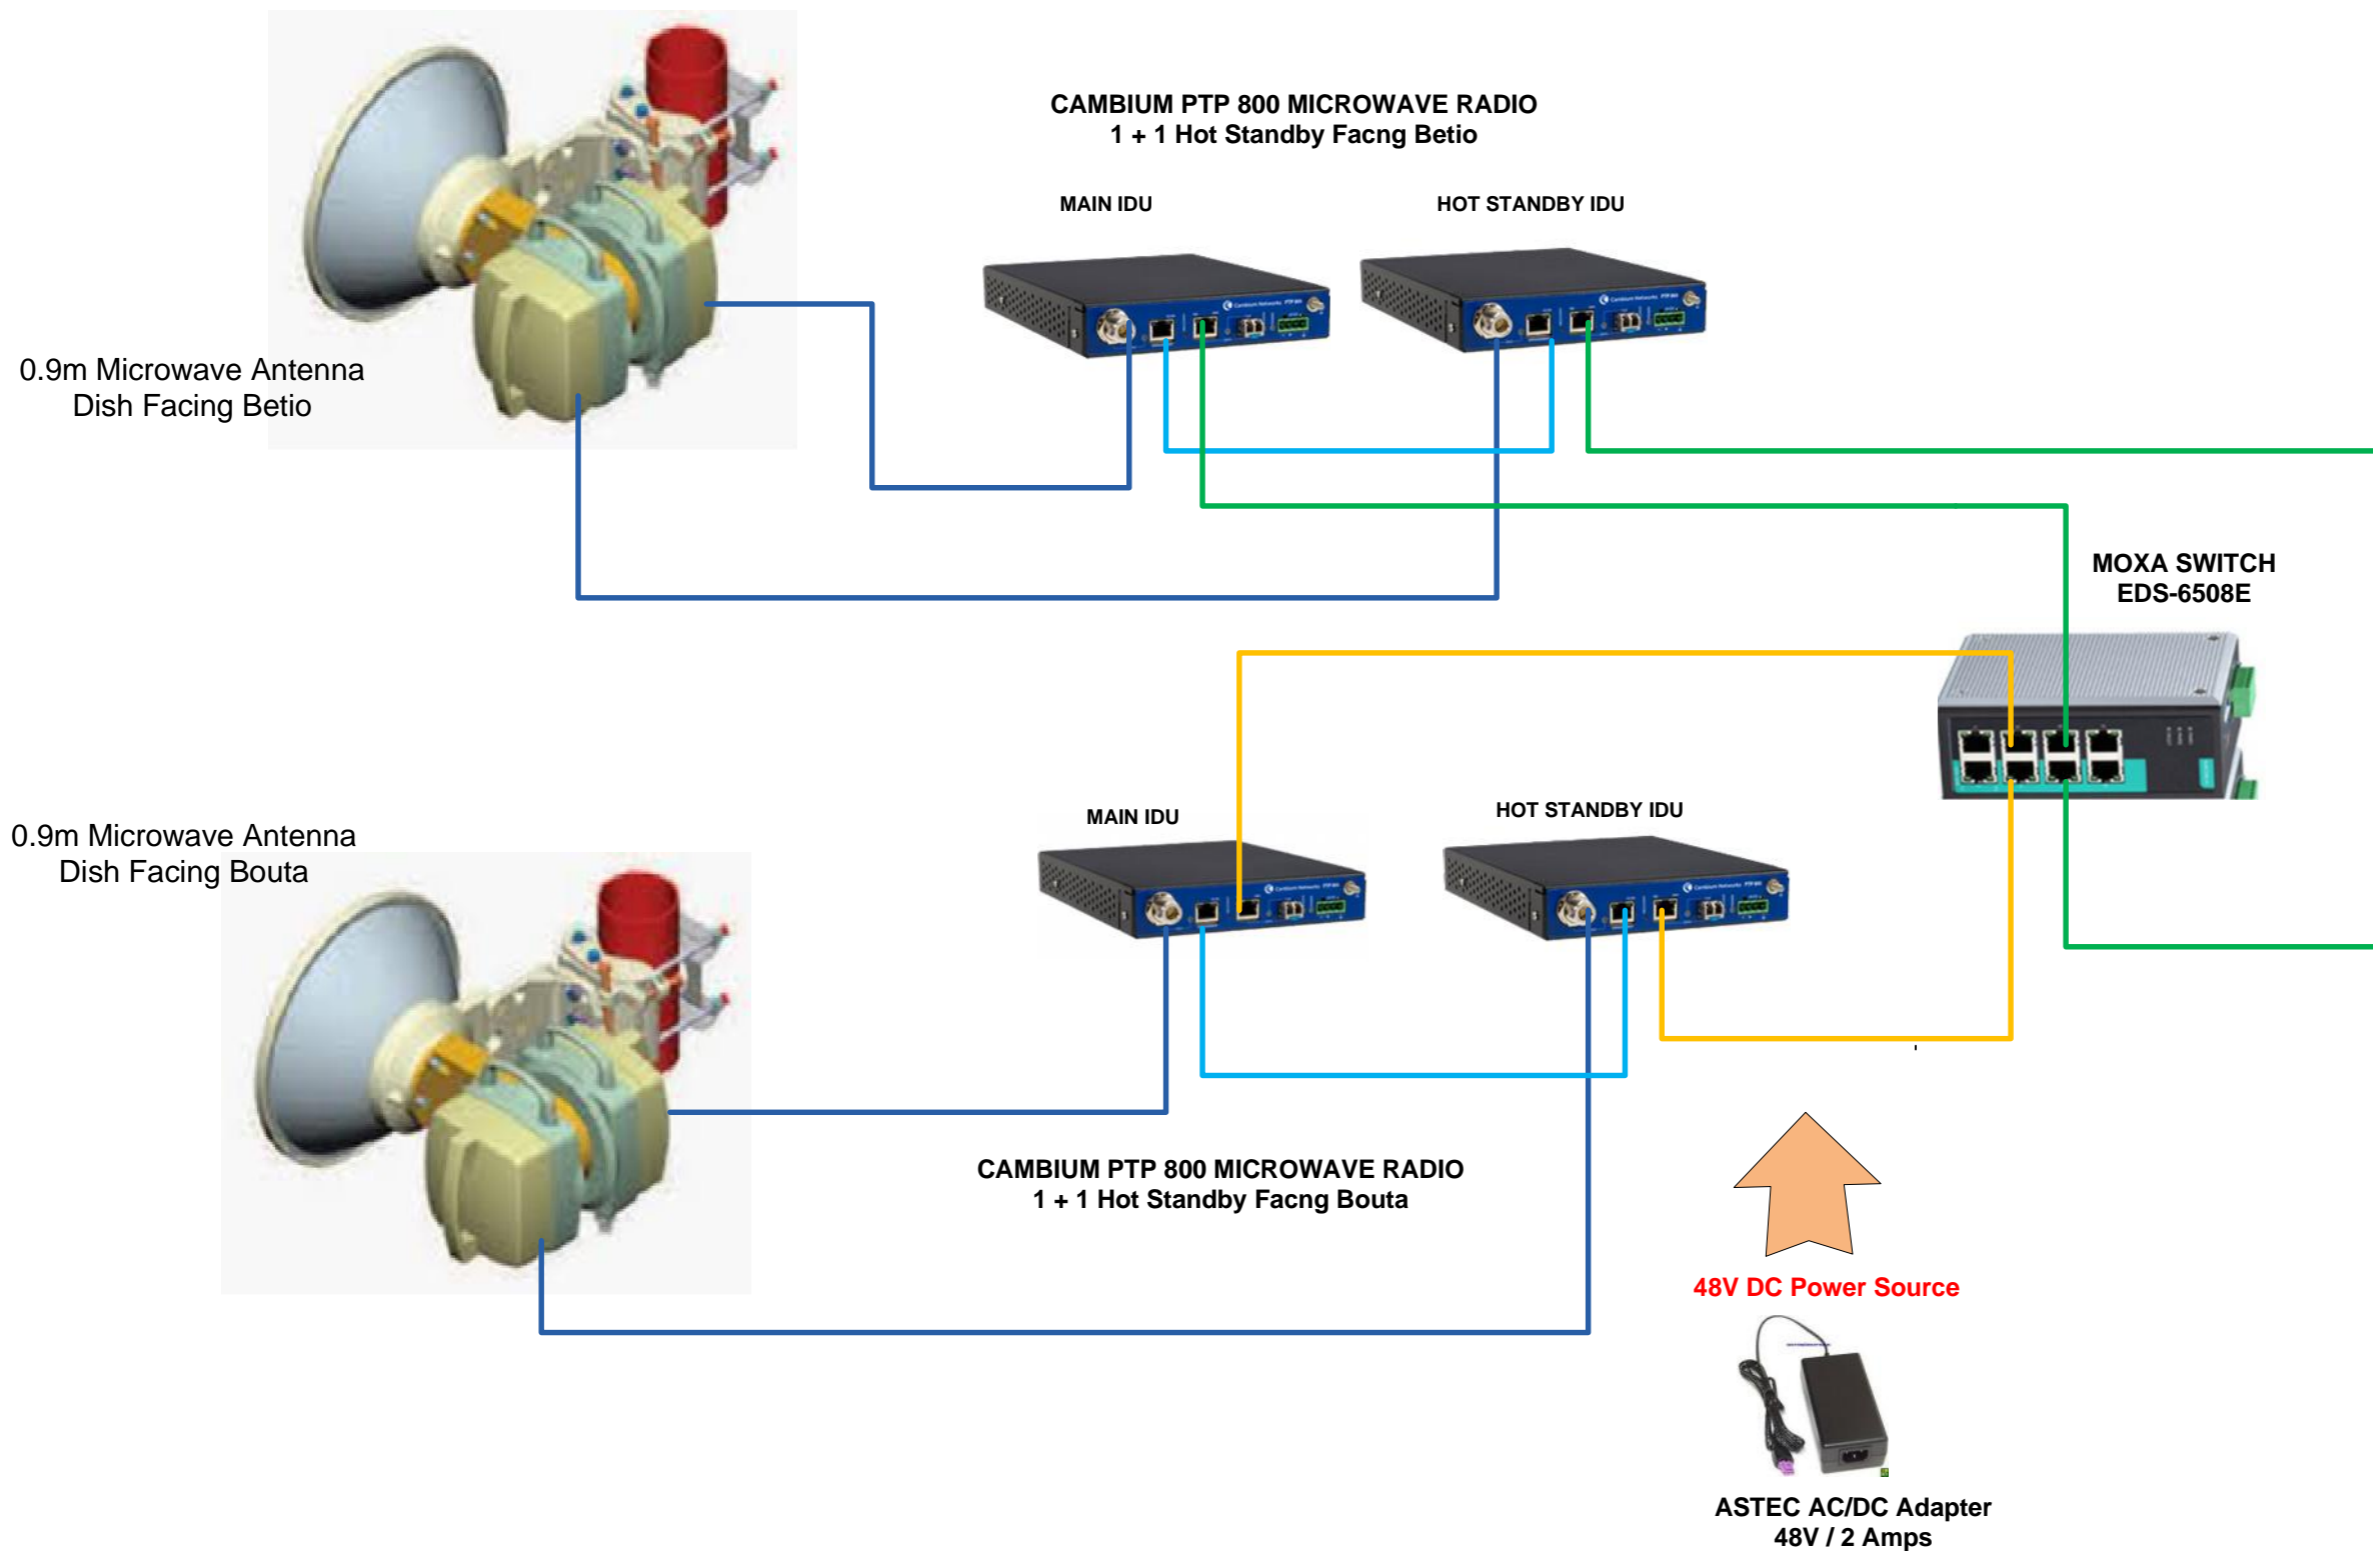

Wireless Innovation Solution Inc.
Design | Supply | Integration | Installation | ITS | Consultation

AMBO NETWORK AS BUILT PLAN



MOEL TRADING COMPANY

Moel Trading House
Betio, Tarawa, REPUBLIC OF KIRIBATI
Ph: +686 26050, 25000, 26654 Fax: +686 26074,
E-mail: moeltrading@hotmail.com

SHEET NO.

1

DATE:

Ref.no.